


Convert Liliha Street to Road Diet; adding Bike Lane on Diamond head Side of the Street; adding bike sharrow on Ewa side of the street

Liliha/School St  
Average Delay (Year 2037)  
AM: 22 Sec  
PM: 21 Sec

Number of Parking spots		
School St to Kuakini St	Before	After
WB (toward Makai)	9	9
EB (toward Mauka)	6	4

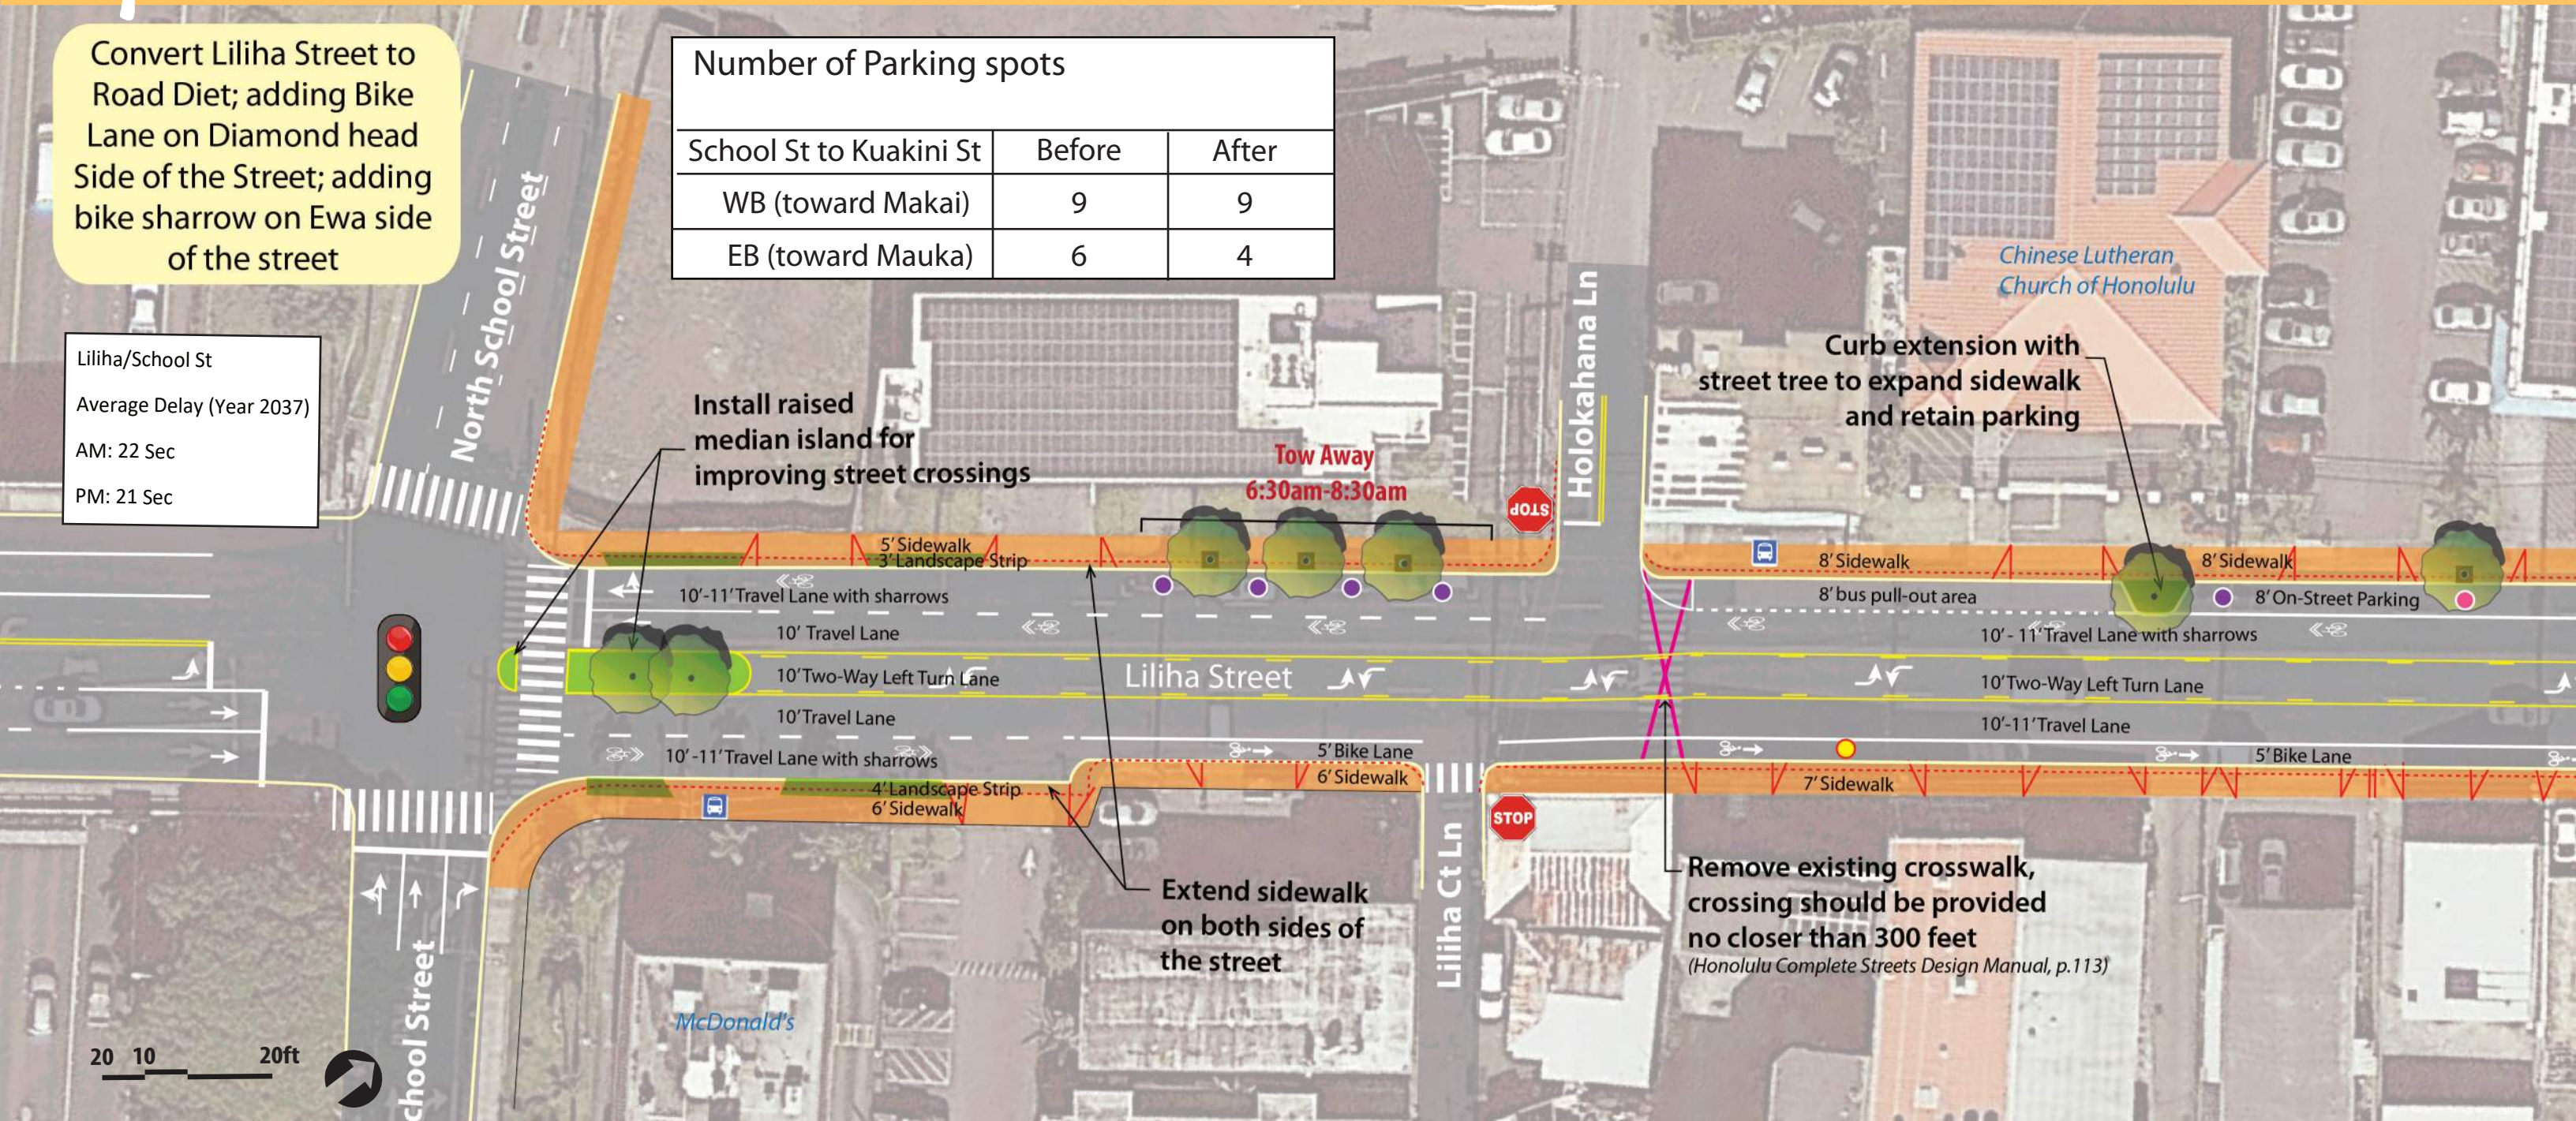

# Liliha Street Proposed Improvements Alternative 2 1

**Legend:**


Signalized Intersection
 Stop Sign
 Bus Stop
 Fire Hydrant

Retain existing parking spot
 Removed existing parking spot
 New parking spot
 Existing Curb Line

Roadway (Gray) with Crosswalk and Stop Lines (Bold White)
 Bike Lane
 Bike Sharrow

Sidewalk (Orange) with Driveway (Redlines) Landscape strip (green) with street tree
 Street tree with tree well
 Raised Median with Landscaping



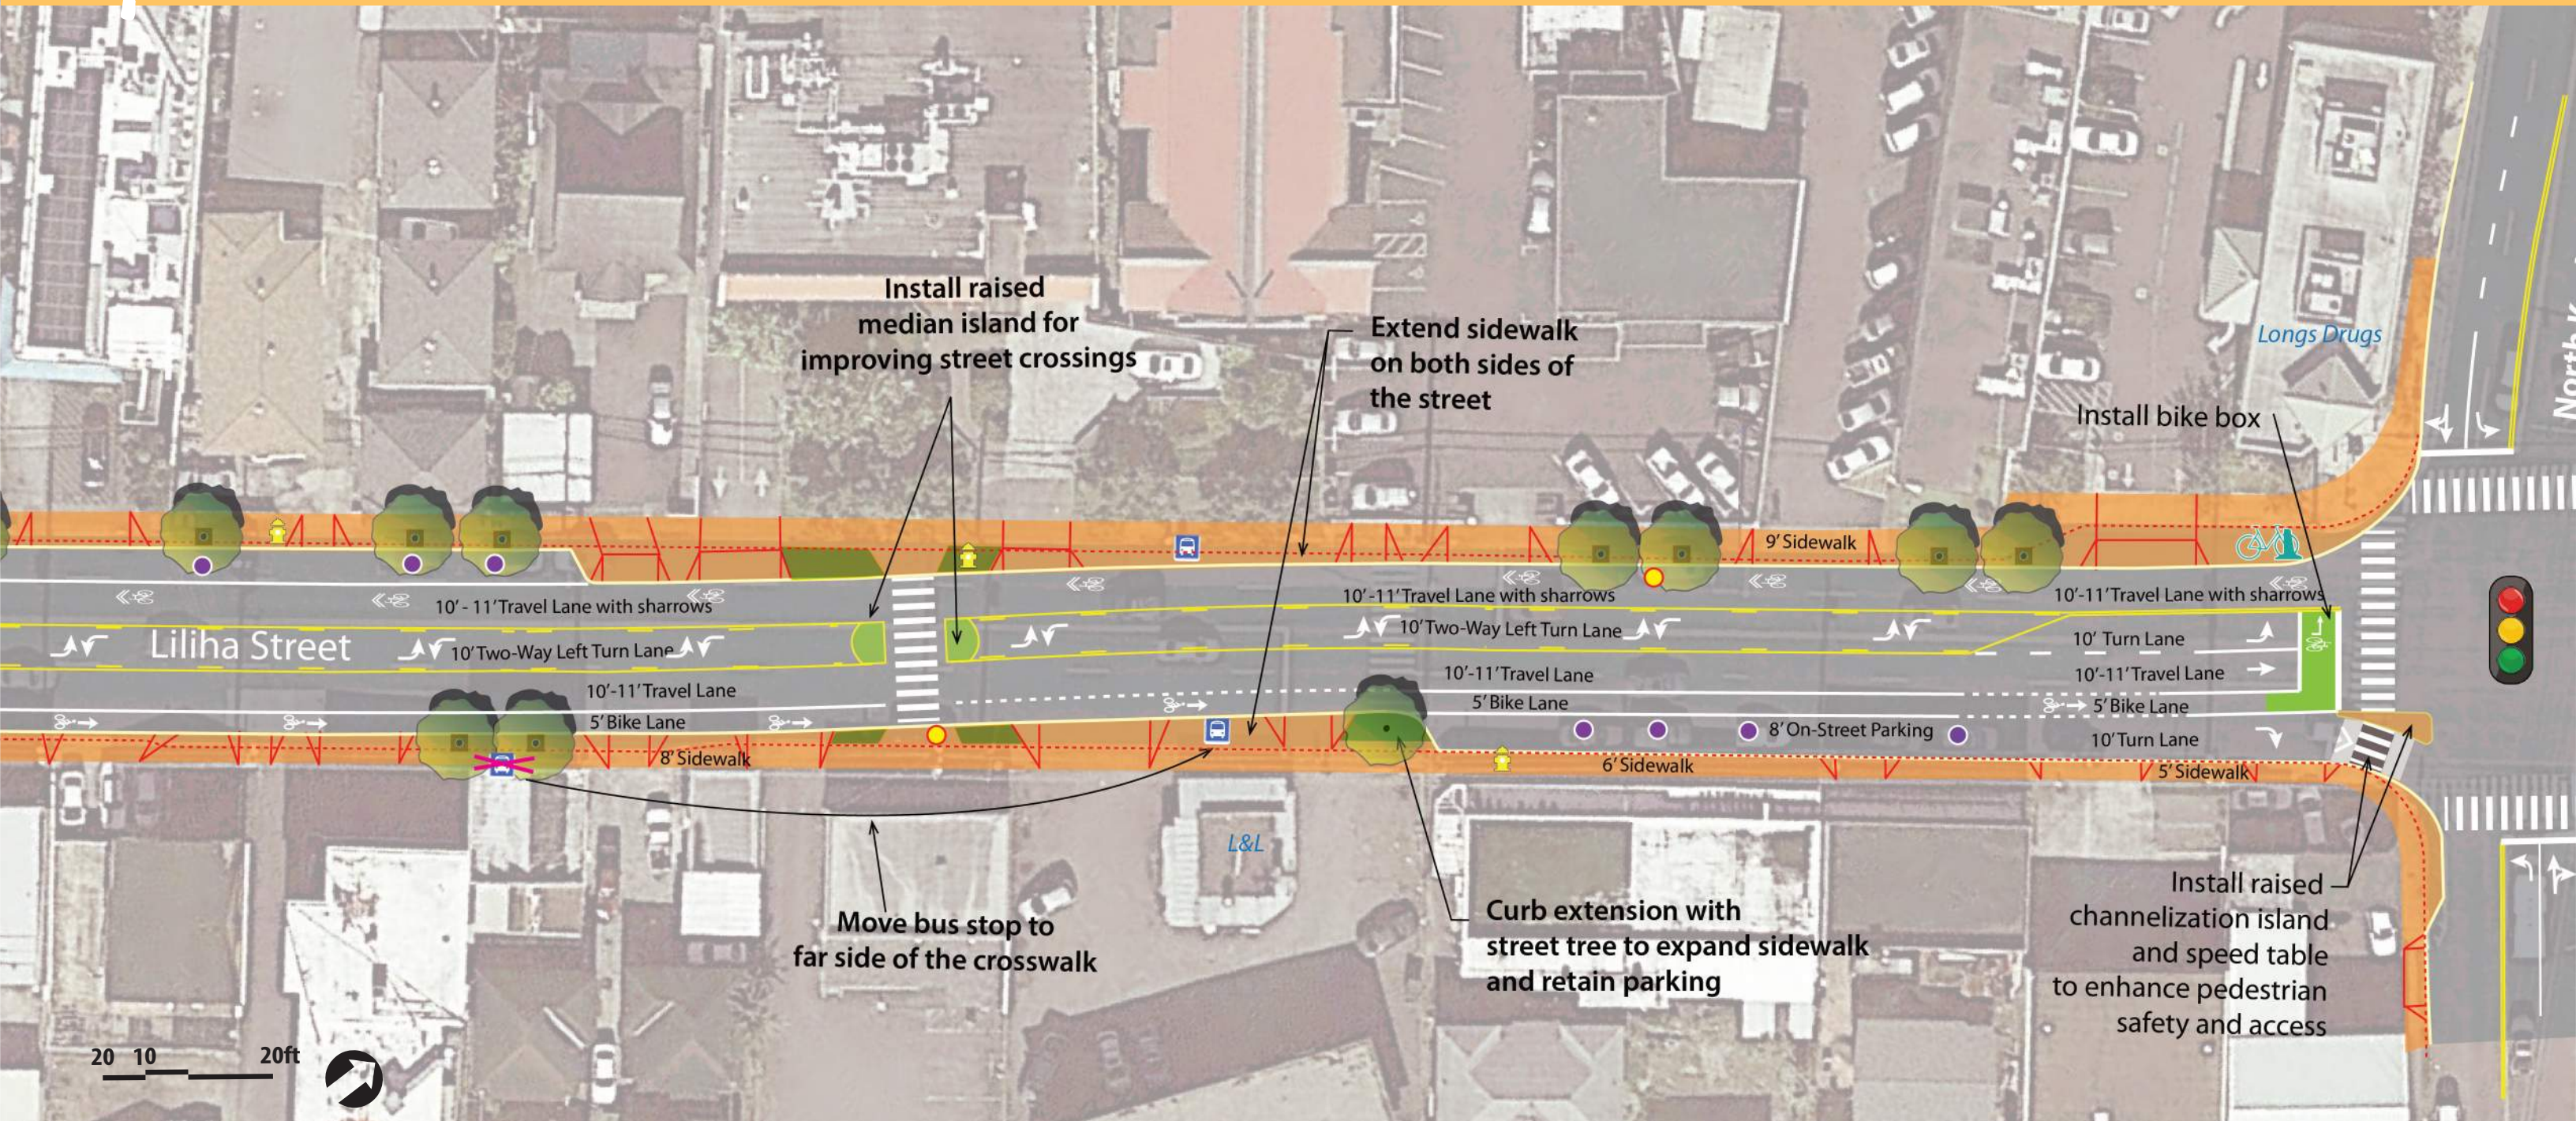

# Liliha Street Proposed Improvements Alternative 2

**Legend:**


Signalized Intersection
 Stop Sign
 Bus Stop
 Fire Hydrant

Retain existing parking spot
 Removed existing parking spot
 New parking spot
 Existing Curb Line

Roadway (Gray) with Crosswalk and Stop Lines (Bold White)
 Bike Lane
 Bike Sharrow

Sidewalk (Orange) with Driveway (Redlines) Landscape strip (green) with street tree
 Street tree with tree well
 Raised Median with Landscaping



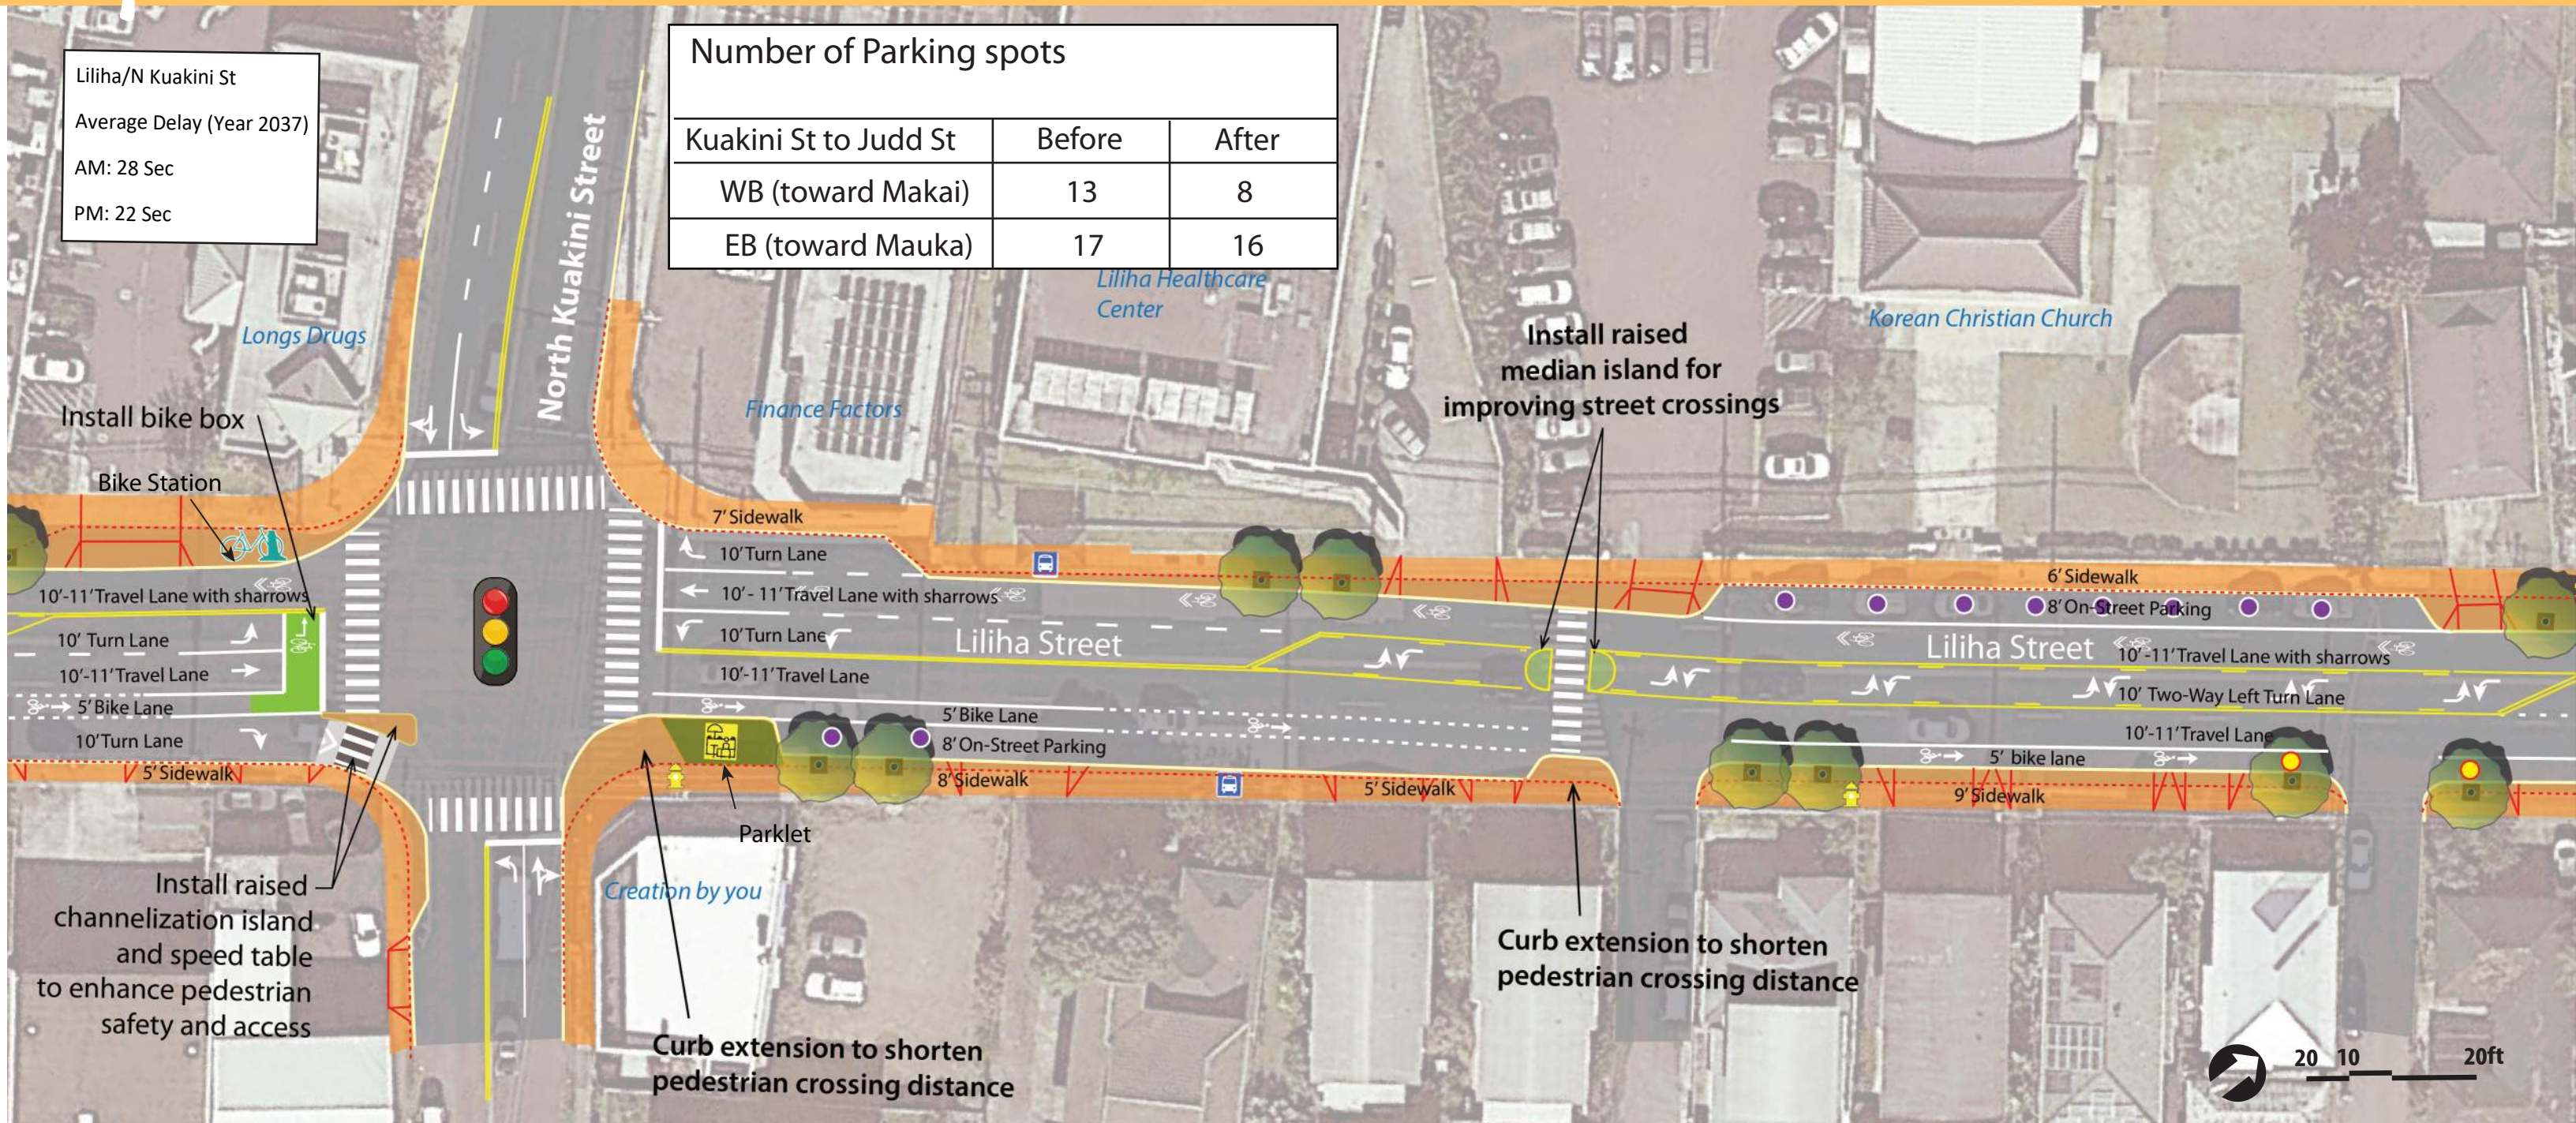

Liliha Street Proposed Improvements Alternative 2

3

Legend:

Signalized Intersection

Stop Sign

Bus Stop

Fire Hydrant

Retain existing parking spot

Removed existing parking spot

New parking spot

Existing Curb Line

Roadway (Gray) with Crosswalk and Stop Lines (Bold White)

Bike Lane

Bike Sharrow

Sidewalk (Orange) with Driveway (Redlines) Landscape strip (green) with street tree

Street tree with tree well

Raised Median with Landscaping





# Liliha Street Proposed Improvements Alternative 2

**Legend:**

Signalized Intersection

Stop Sign

Bus Stop

Fire Hydrant

Retain existing parking spot

Removed existing parking spot

New parking spot

Existing Curb Line

Roadway (Gray) with Crosswalk and Stop Lines (Bold White)

Bike Lane


Bike Sharrows

Sidewalk (Orange) with Driveway (Redlines) Landscape strip (green) with street tree

Street tree with tree well

Raised Median with Landscaping



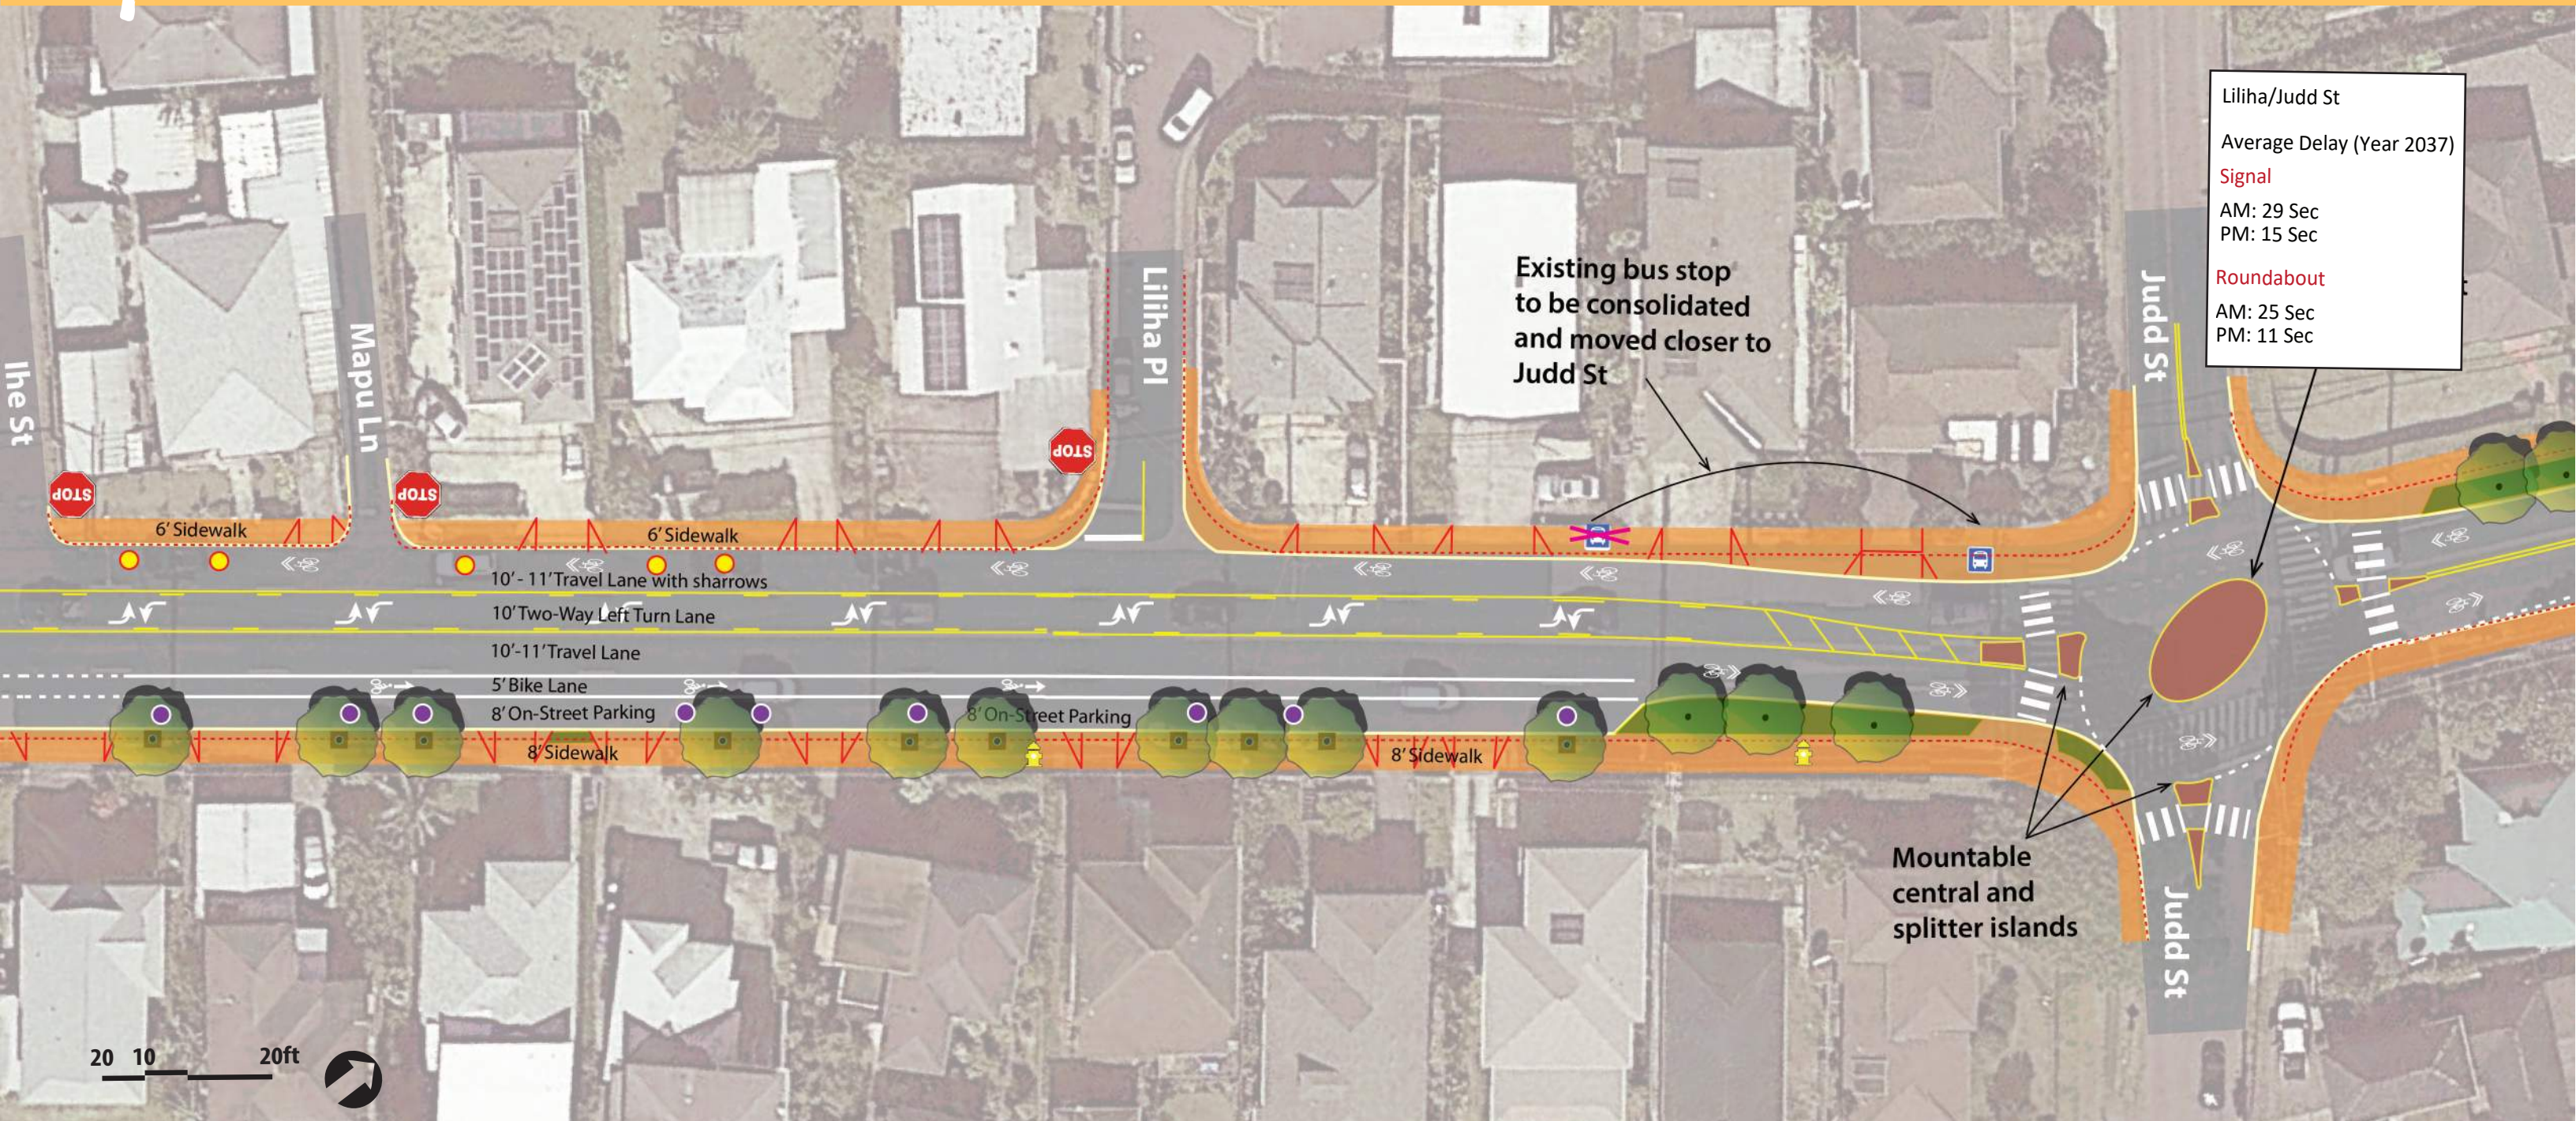


# Liliha Street Proposed Improvements Alternative 2

**Legend:**

- |  |                         |  |                               |  |   |  |   |
|--|-------------------------|--|-------------------------------|--|---|--|---|
|  | Signalized Intersection |  | Retain existing parking spot  |  | Roadway (Gray) with Crosswalk and Stop Lines (Bold White) |  | Sidewalk (Orange) with Driveway (Redlines) Landscape strip (green) with street tree |
|  | Stop Sign               |  | Removed existing parking spot |  | Bike Lane   |  | Street tree with tree well  |
|  | Bus Stop                |  | New parking spot              |  | Bike Sharrow  |  | Raised Median with Landscaping  |
|  | Fire Hydrant            |  | Existing Curb Line            |  |   |  |   |



Number of Parking spots		
Judd St to Wyllie St	Before	After
WB (toward Makai)	26	30
EB (toward Mauka)	15	0

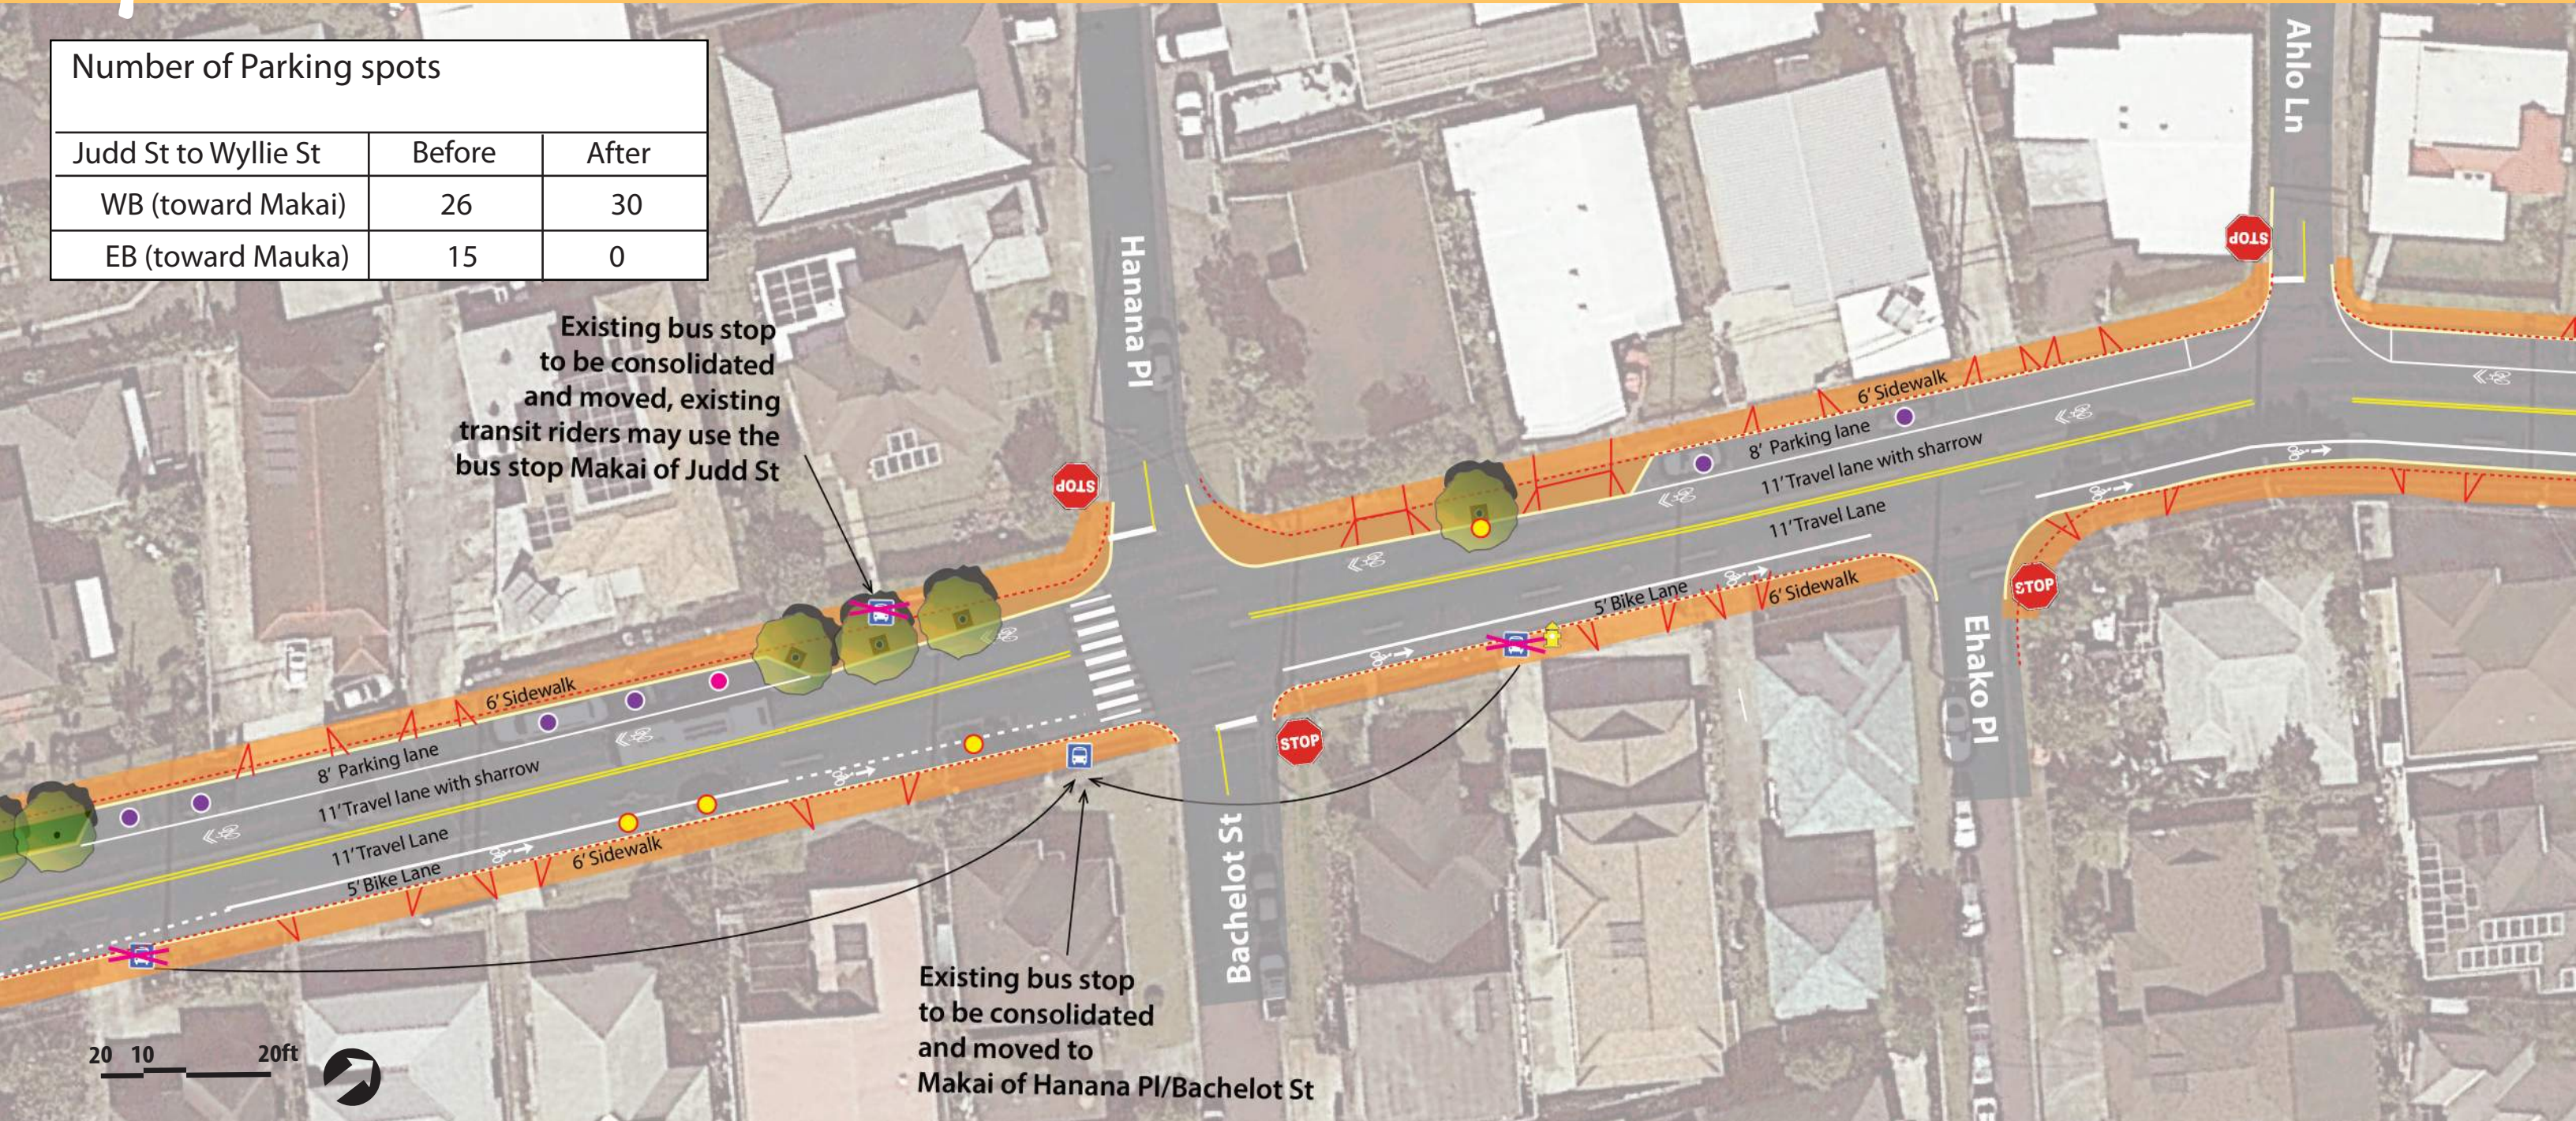

Liliha Street Proposed Improvements Alternative 2

6

Legend:

Signalized Intersection

Stop Sign

Bus Stop

Fire Hydrant

Retain existing parking spot

Removed existing parking spot

New parking spot

Existing Curb Line

Roadway (Gray) with Crosswalk and Stop Lines (Bold White)

Bike Lane


Bike Sharrow

Sidewalk (Orange) with Driveway (Redlines) Landscape strip (green) with street tree

Street tree with tree well

Raised Median with Landscaping



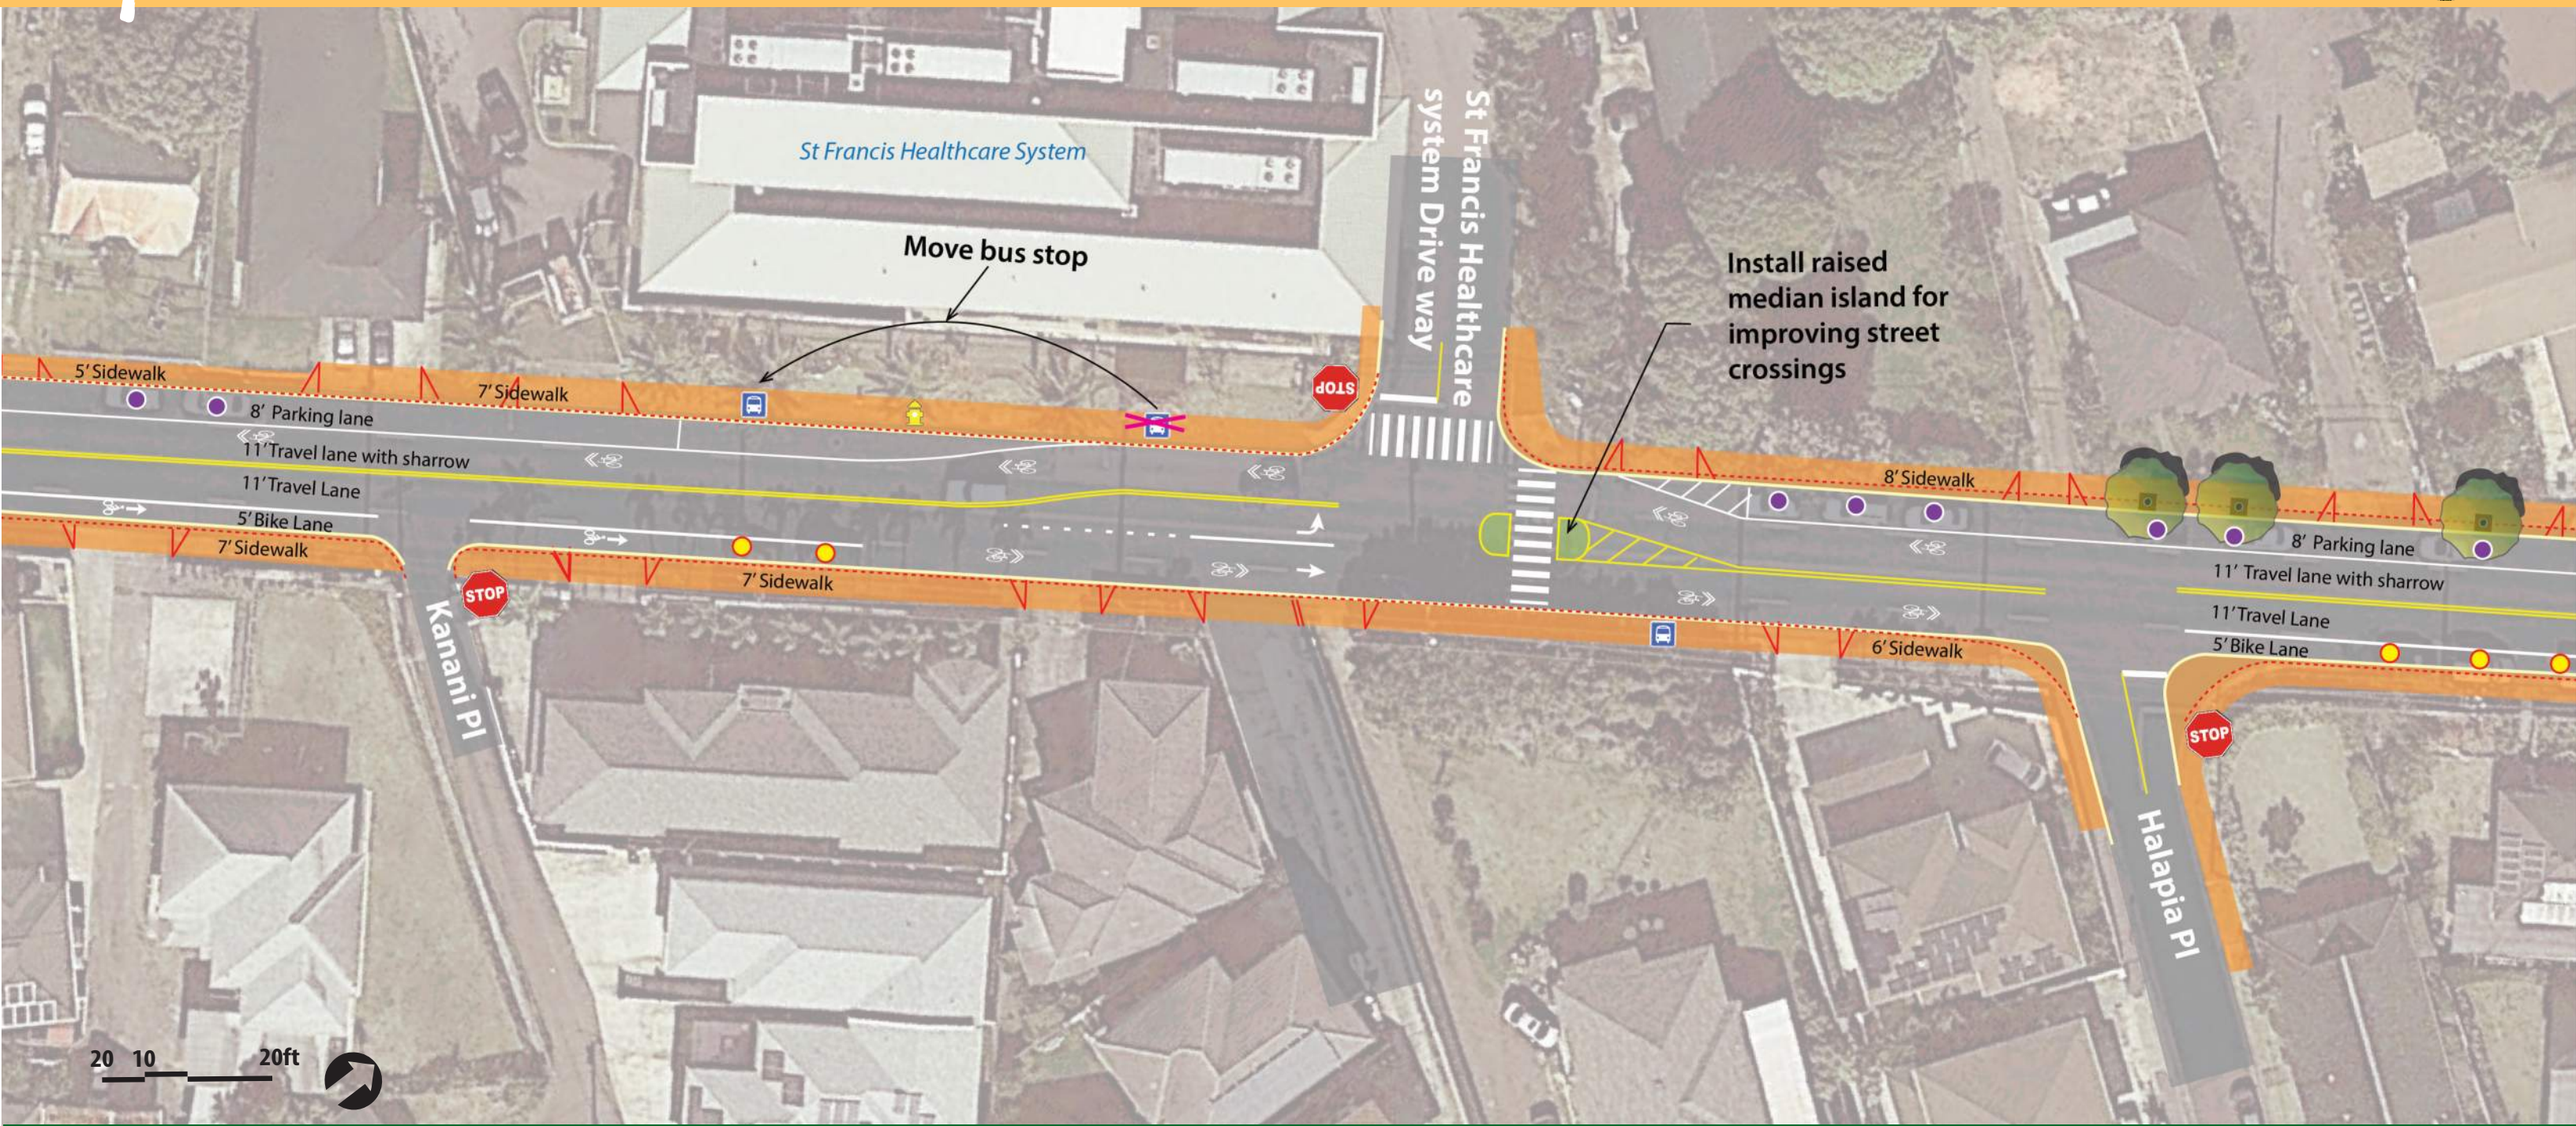


# Liliha Street Proposed Improvements Alternative 2

**Legend:**

- |  |                         |  |                               |  |   |  |   |
|--|-------------------------|--|-------------------------------|--|---|--|---|
|  | Signalized Intersection |  | Retain existing parking spot  |  | Roadway (Gray) with Crosswalk and Stop Lines (Bold White) |  | Sidewalk (Orange) with Driveway (Redlines) Landscape strip (green) with street tree |
|  | Stop Sign               |  | Removed existing parking spot |  | Bike Lane   |  | Street tree with tree well  |
|  | Bus Stop                |  | New parking spot              |  | Bike Sharrow  |  | Raised Median with Landscaping  |
|  | Fire Hydrant            |  | Existing Curb Line            |  |   |  |   |



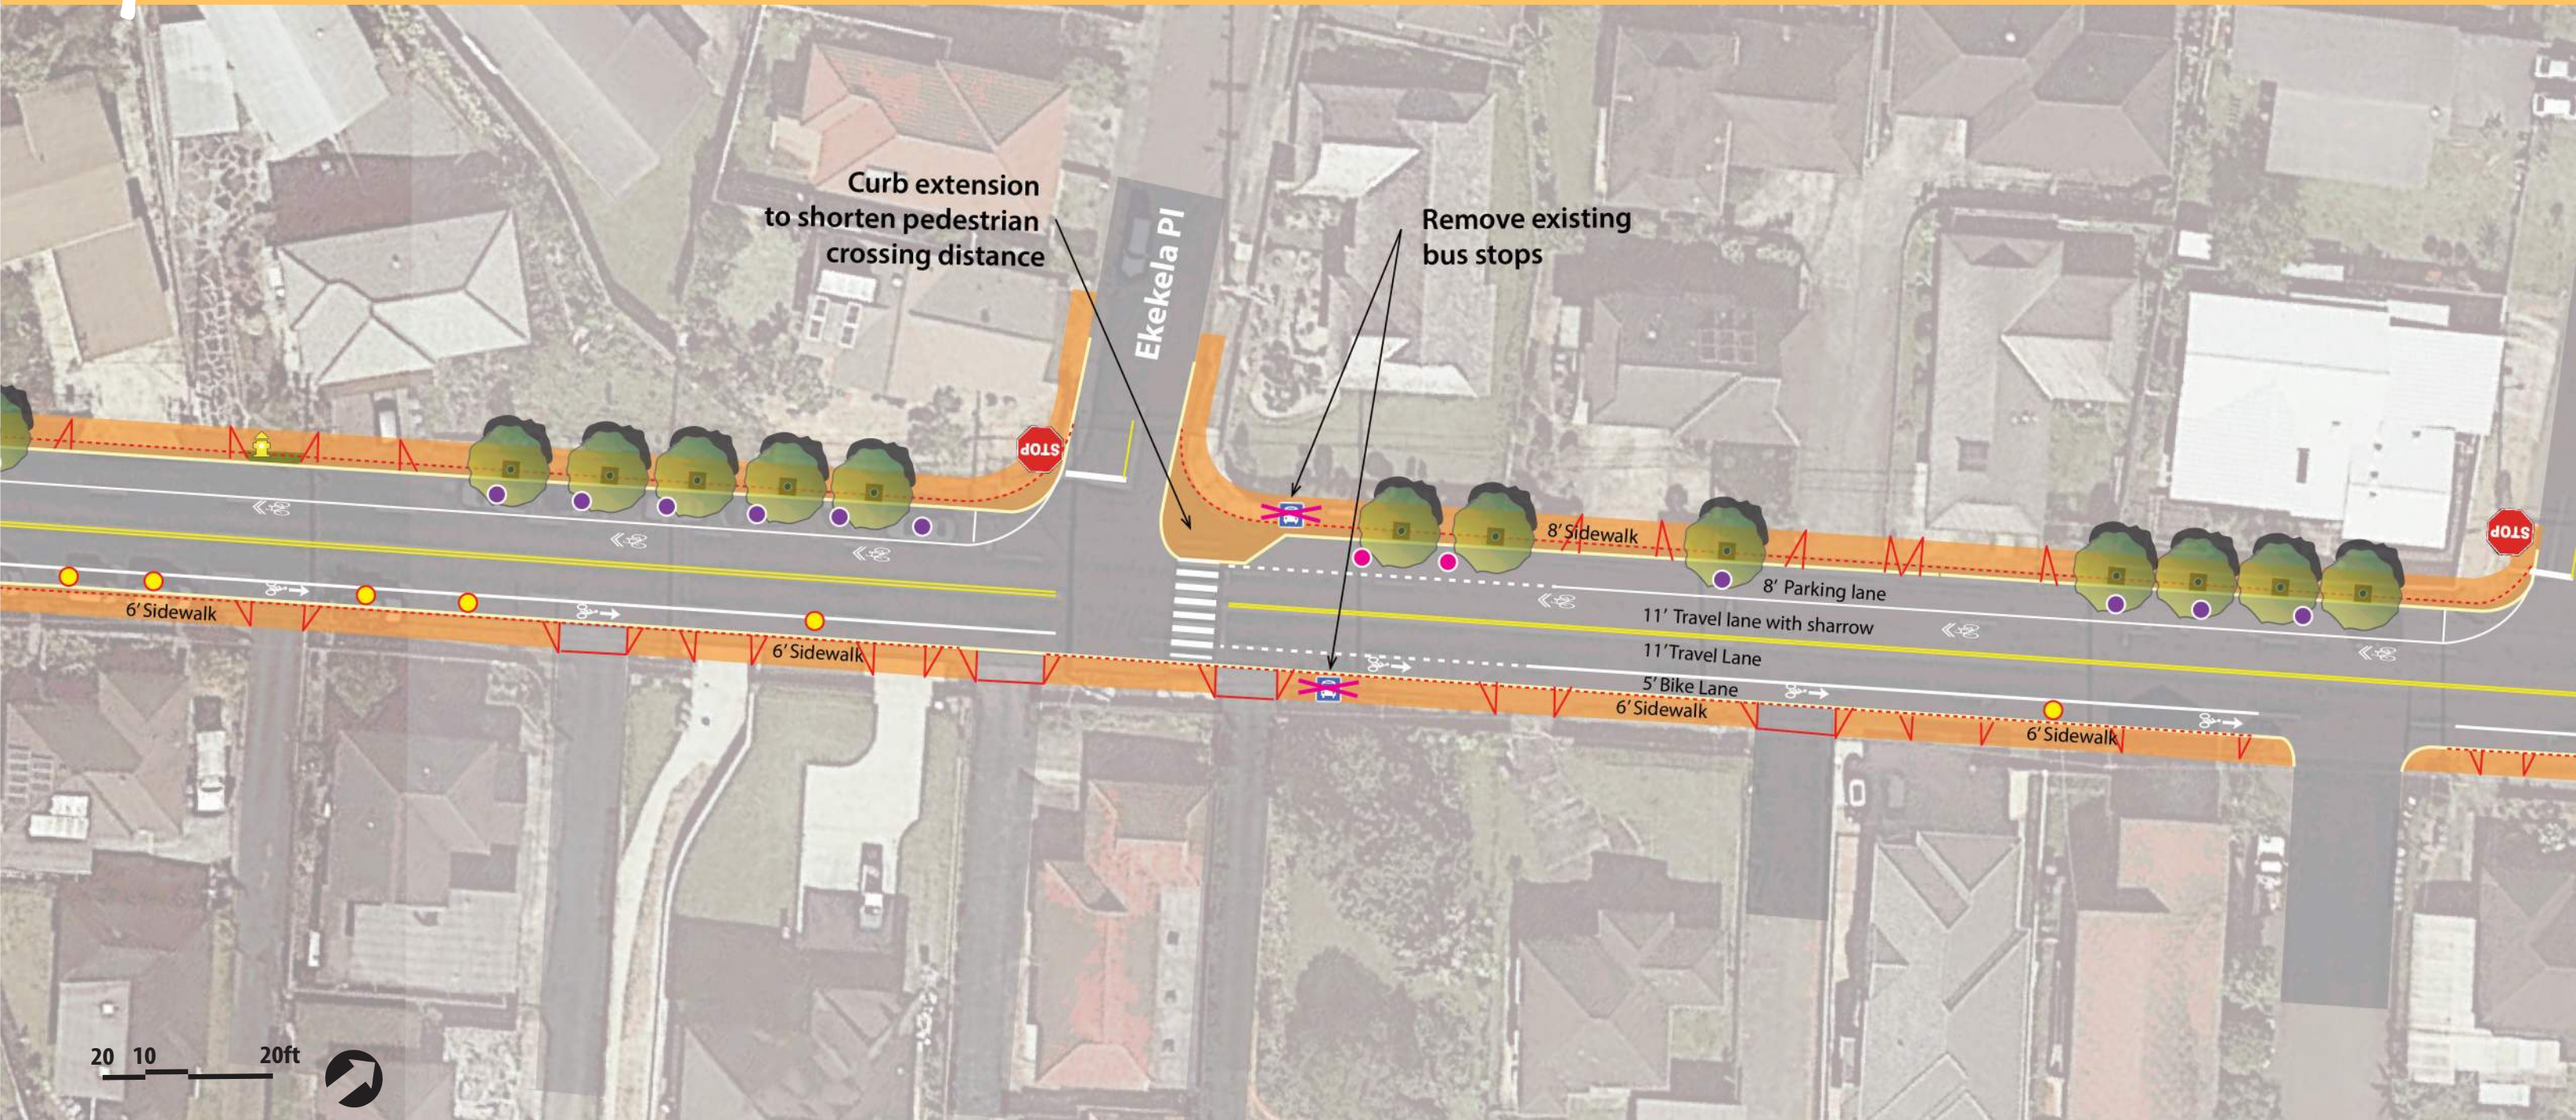

# Liliha Street Proposed Improvements Alternative 2

**Legend:**


Signalized Intersection
 Stop Sign
 Bus Stop
 Fire Hydrant

Retain existing parking spot
 Removed existing parking spot
 New parking spot
 Existing Curb Line

Roadway (Gray) with Crosswalk and Stop Lines (Bold White)
 Bike Lane
 Bike Sharrow

Sidewalk (Orange) with Driveway (Redlines) Landscape strip (green) with street tree
 Street tree with tree well
 Raised Median with Landscaping



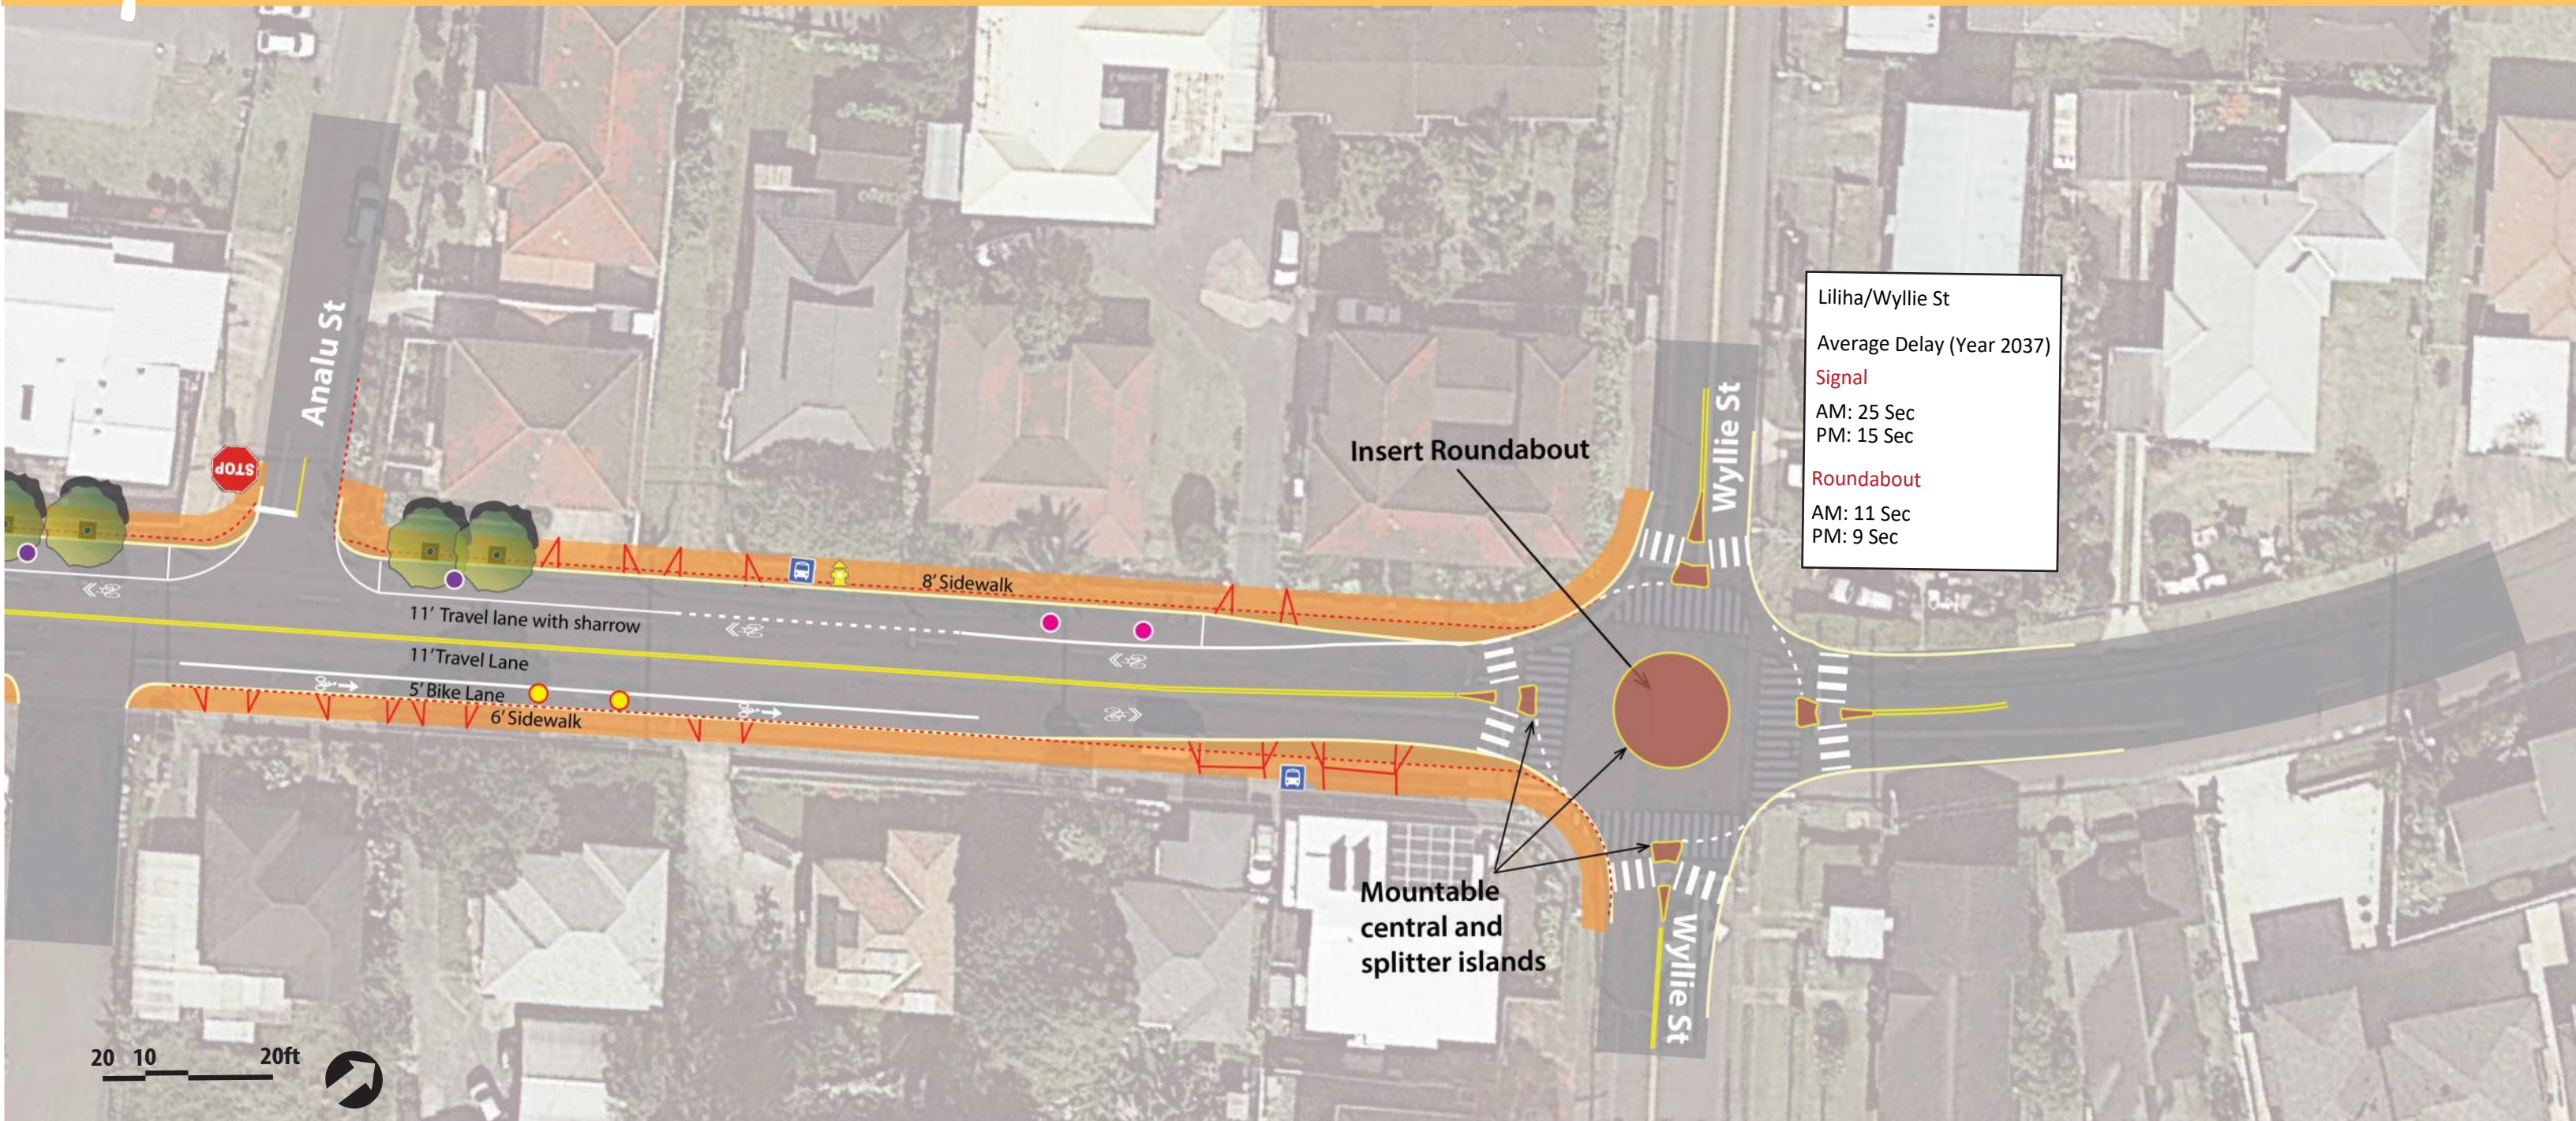

Liliha/Wyllie St  
Average Delay (Year 2037)  
**Signal**  
AM: 25 Sec  
PM: 15 Sec  
**Roundabout**  
AM: 11 Sec  
PM: 9 Sec

# Liliha Street Proposed Improvements Alternative 2

**Legend:**

Signalized Intersection
 Stop Sign
 Bus Stop
 Fire Hydrant

Retain existing parking spot
 Removed existing parking spot
 New parking spot
 Existing Curb Line

Roadway (Gray) with Crosswalk and Stop Lines (Bold White)
 Bike Lane
 Bike Sharrow

Sidewalk (Orange) with Driveway (Redlines) Landscape strip (green) with street tree
 Street tree with tree well
 Raised Median with Landscaping